


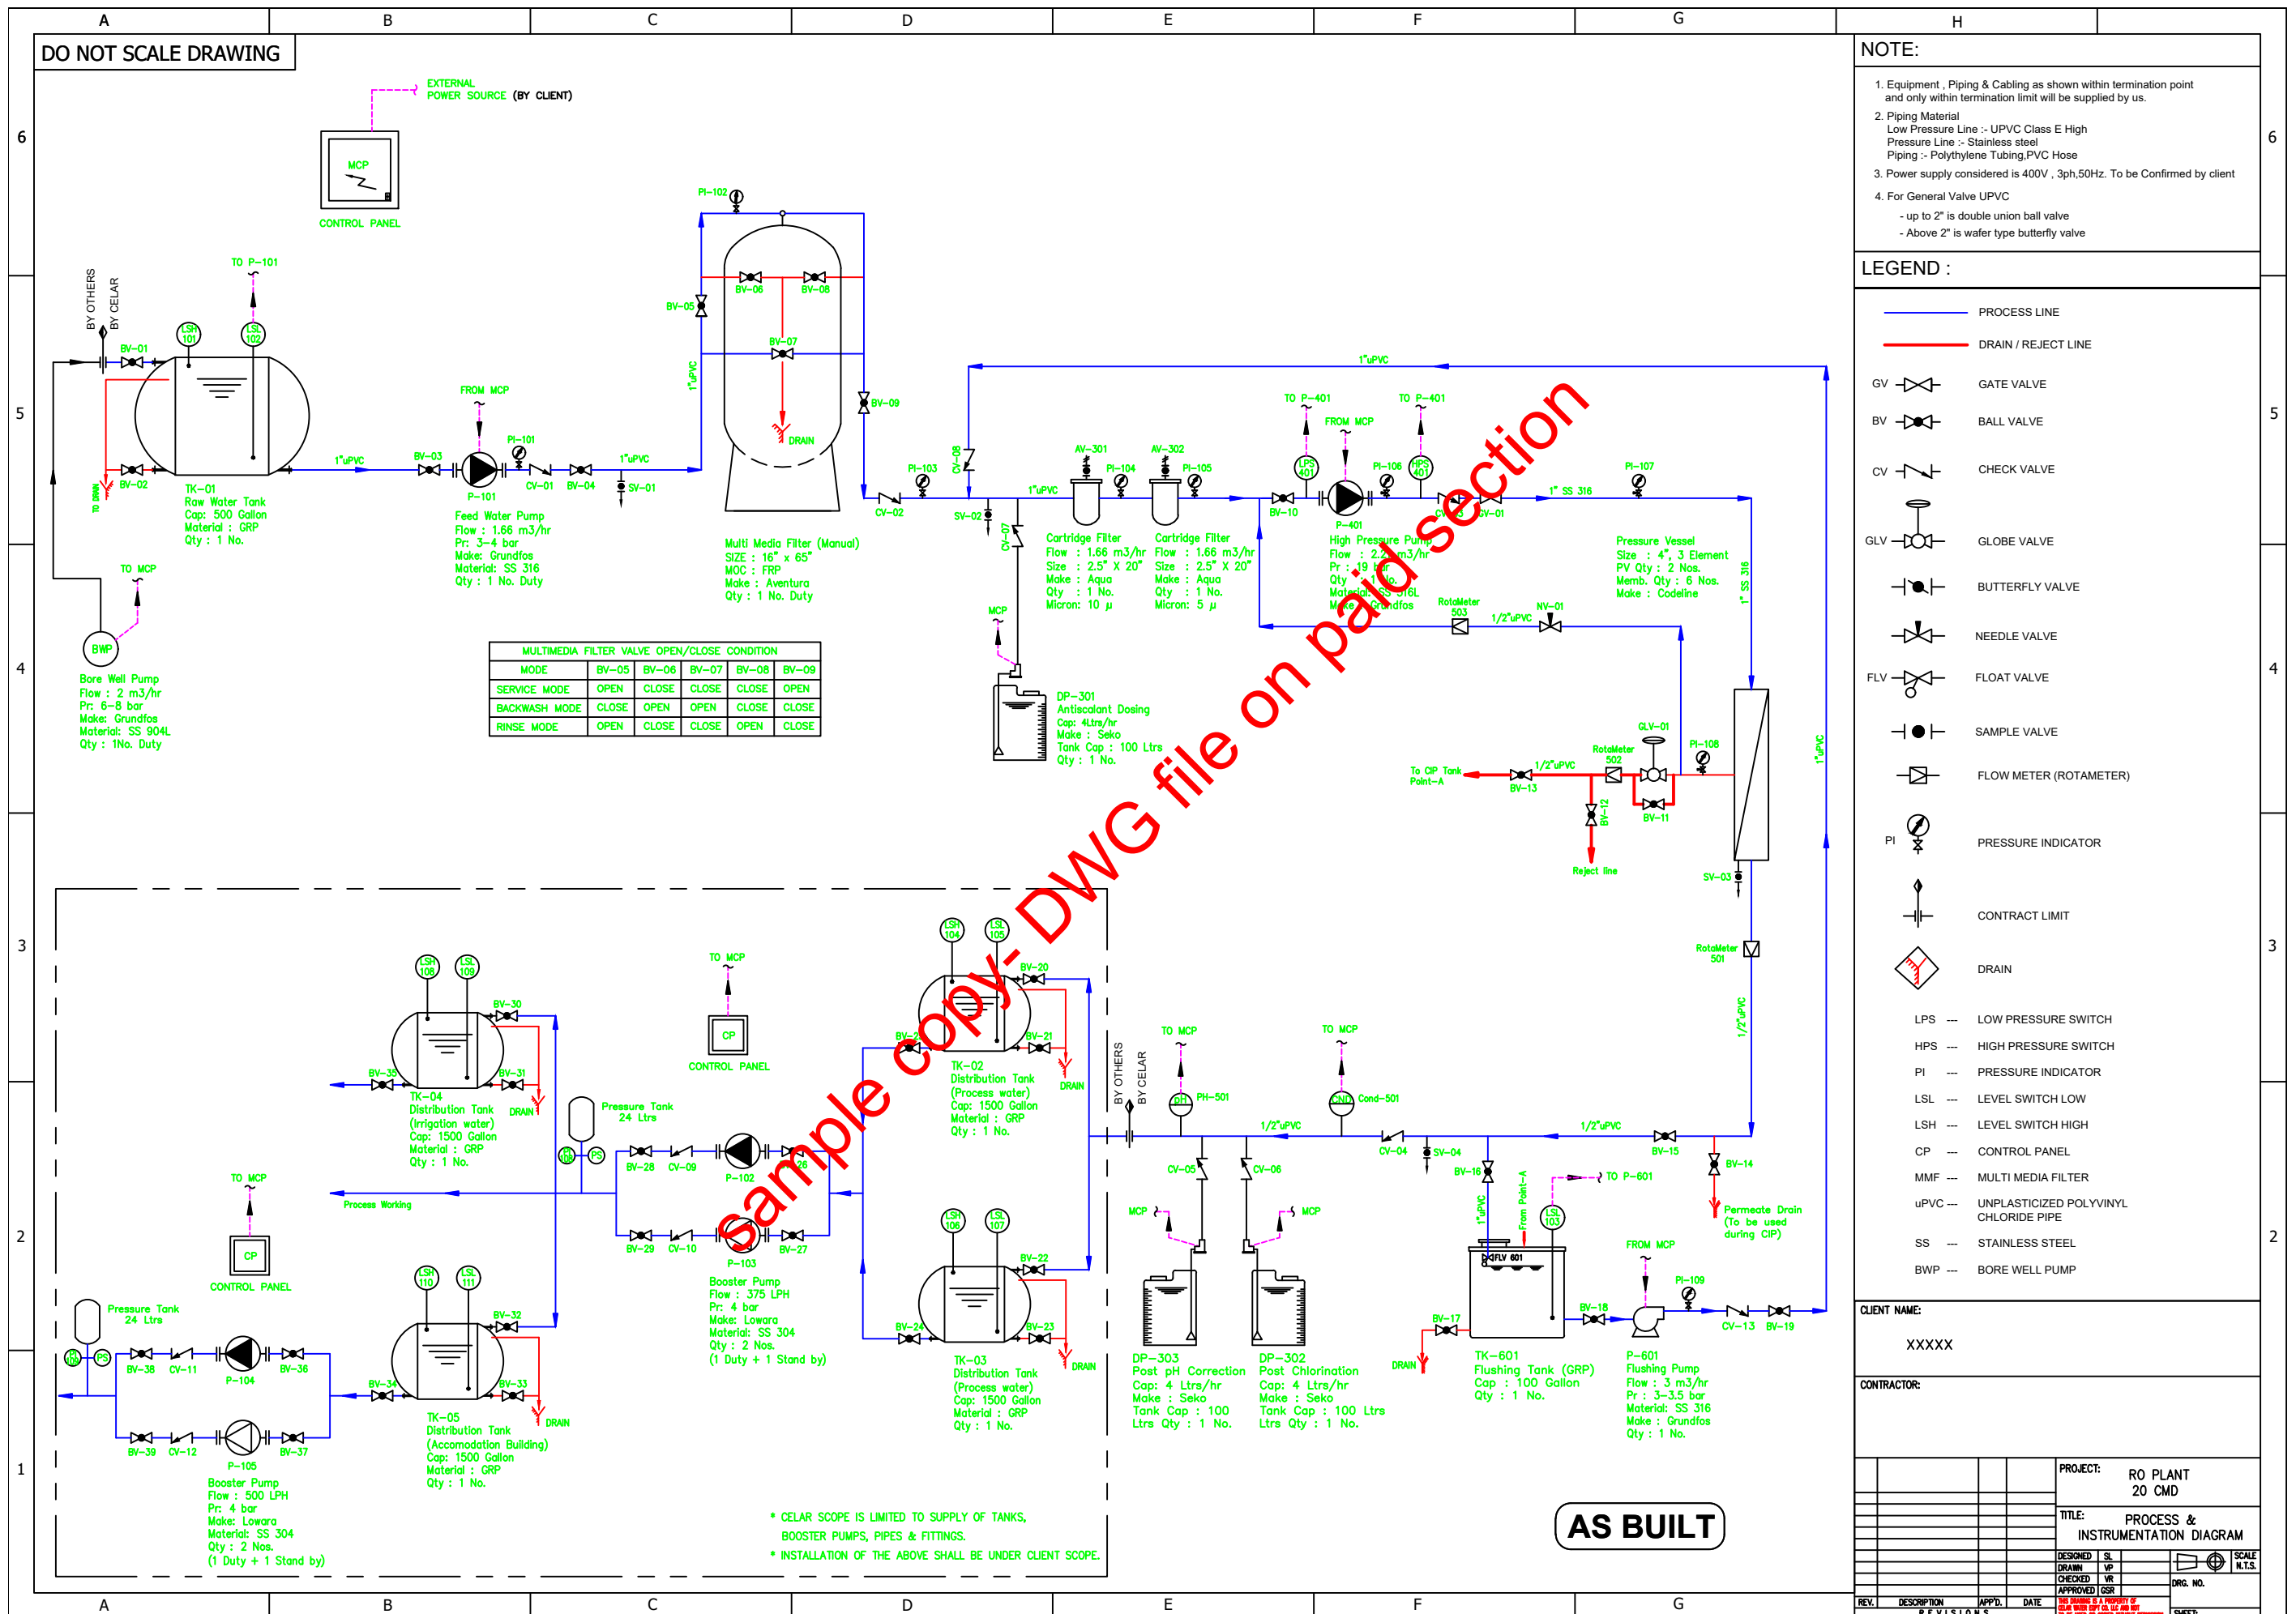
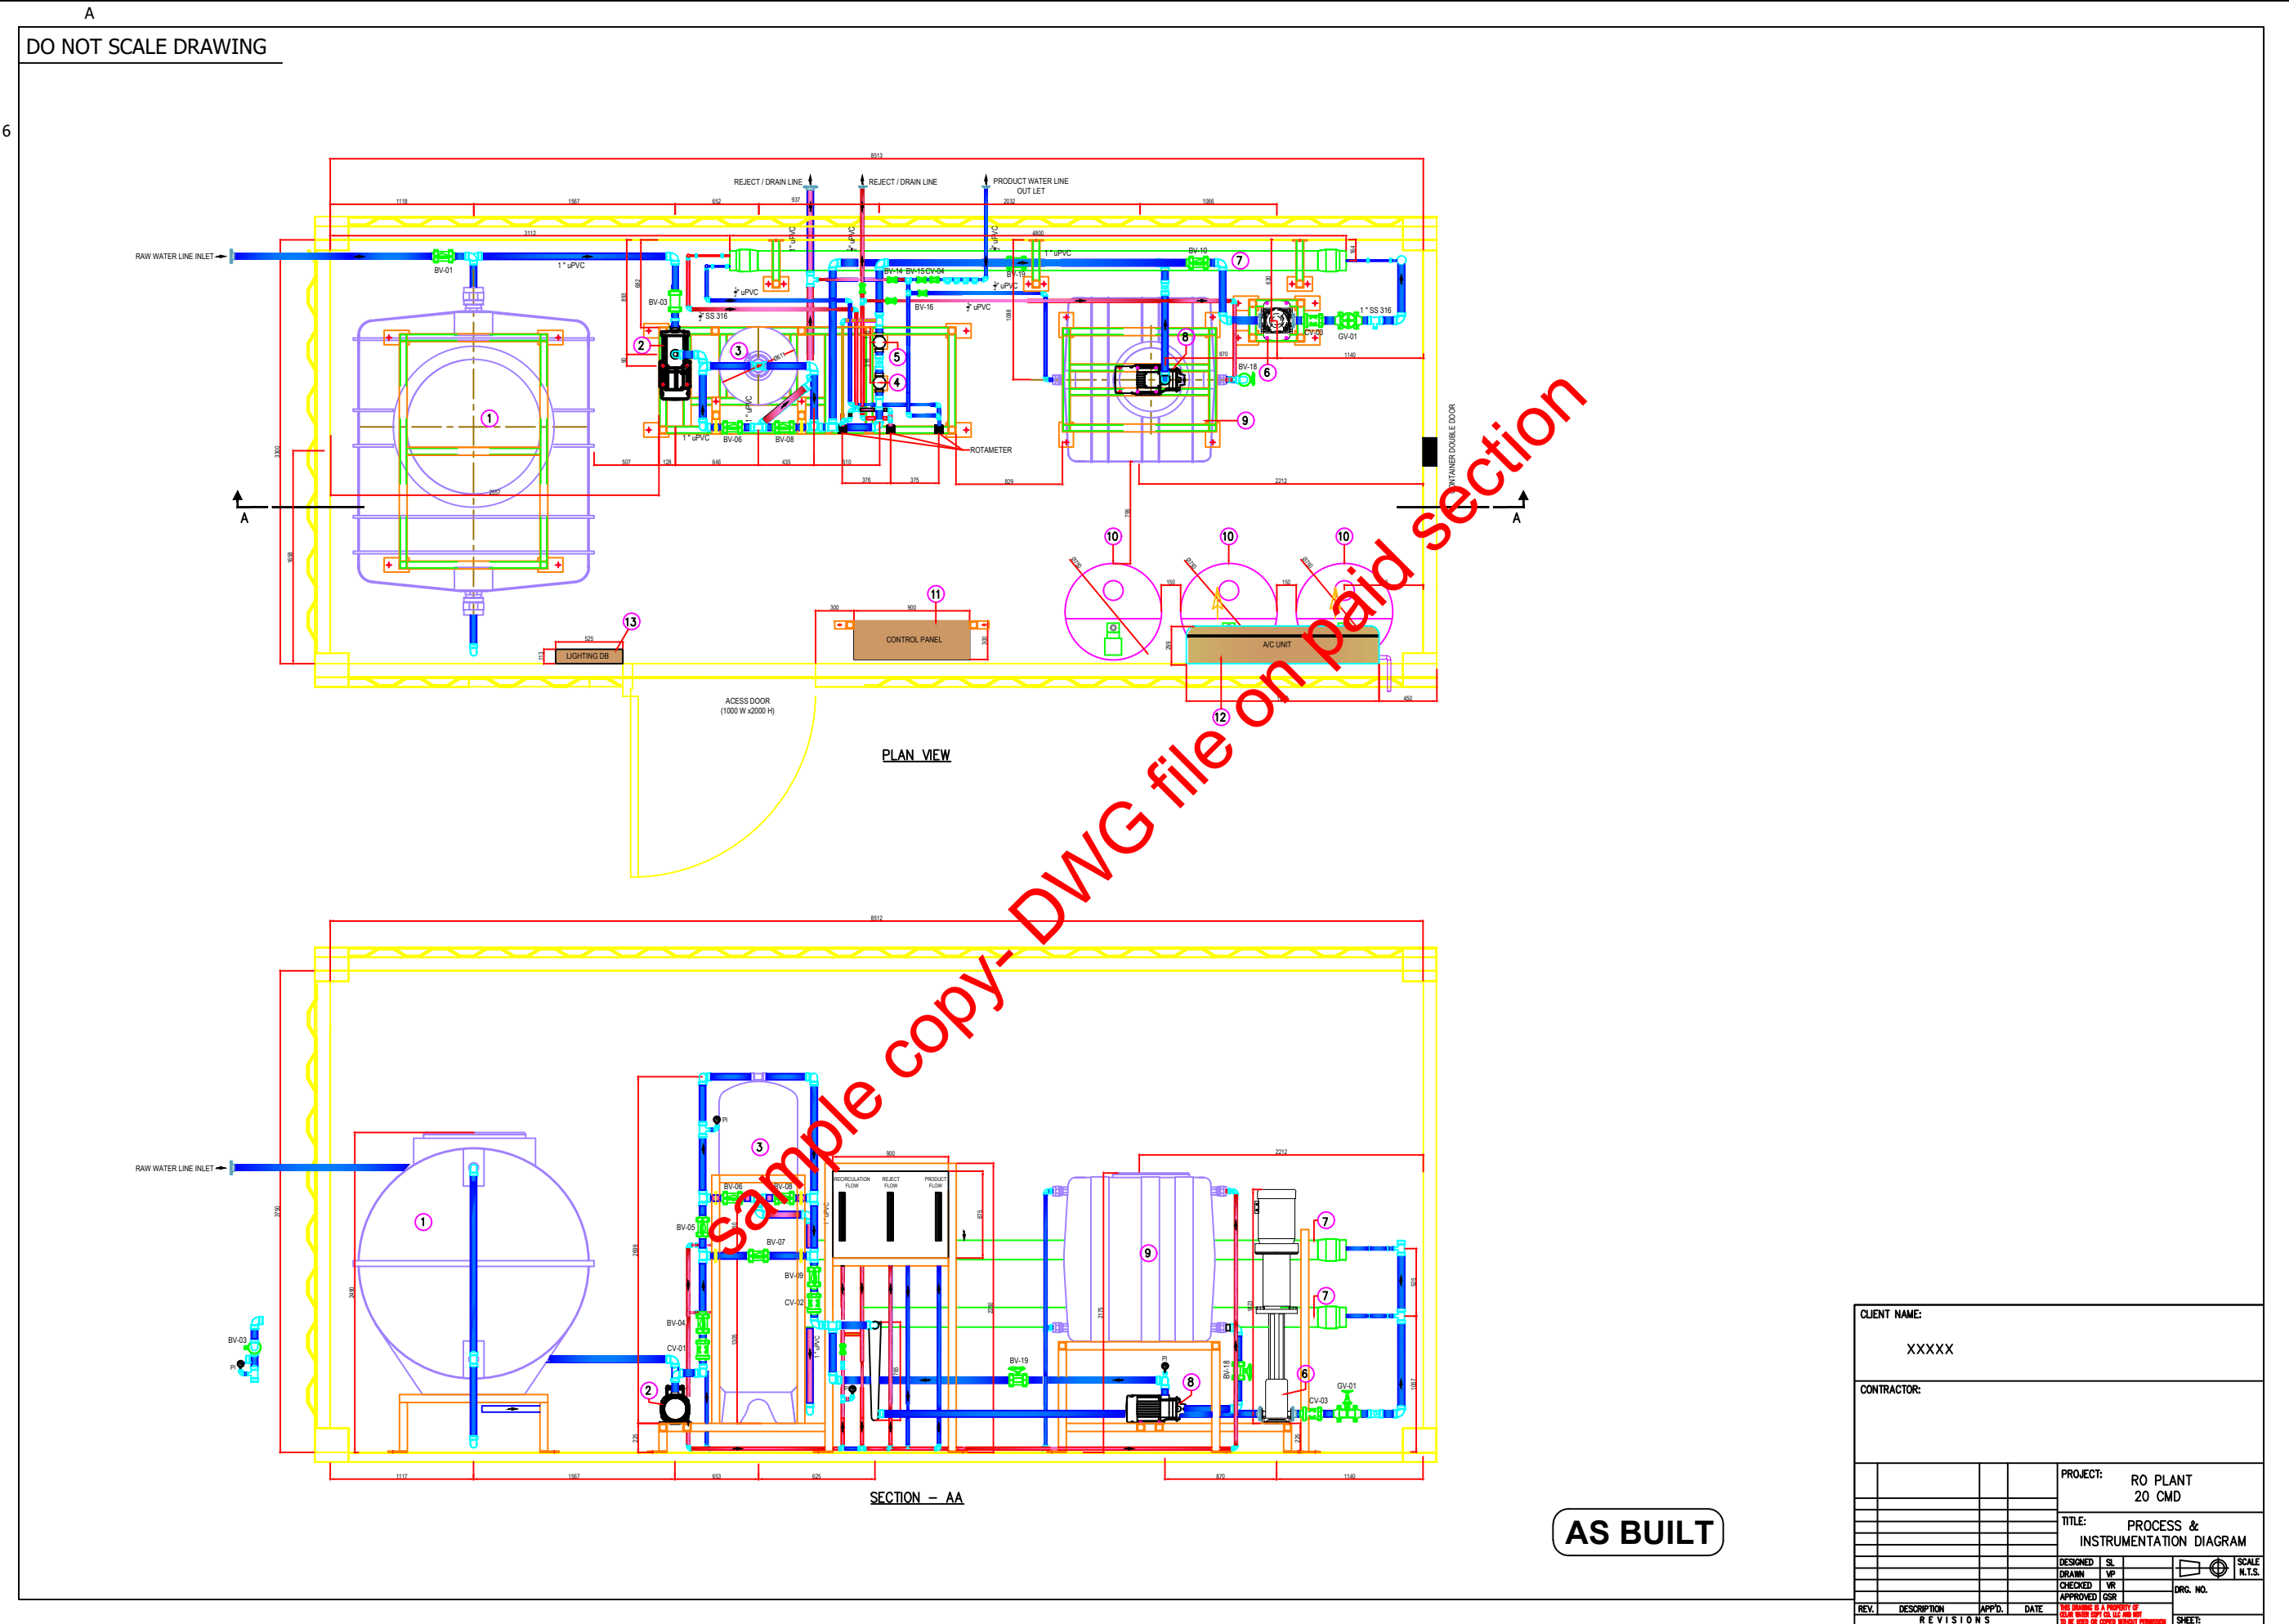
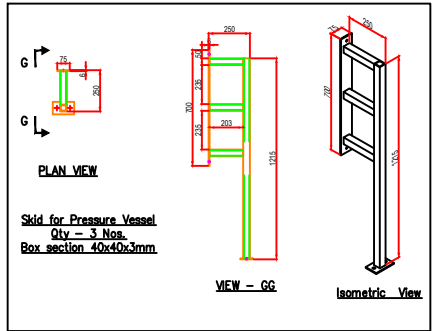
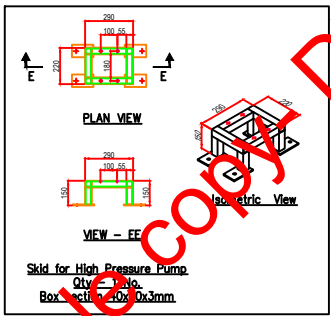
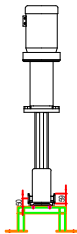
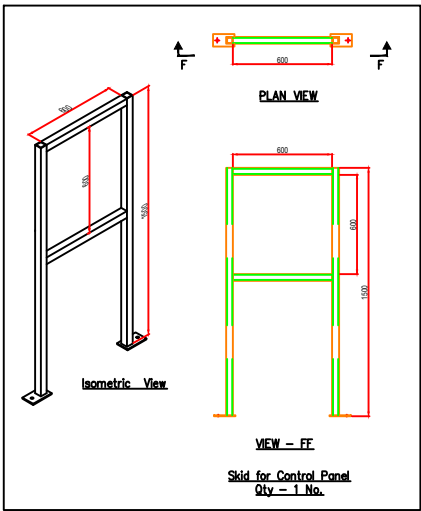
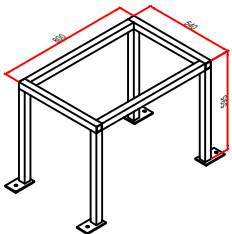


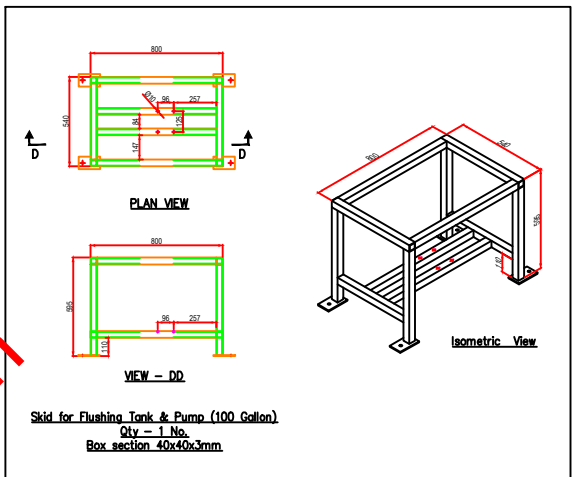

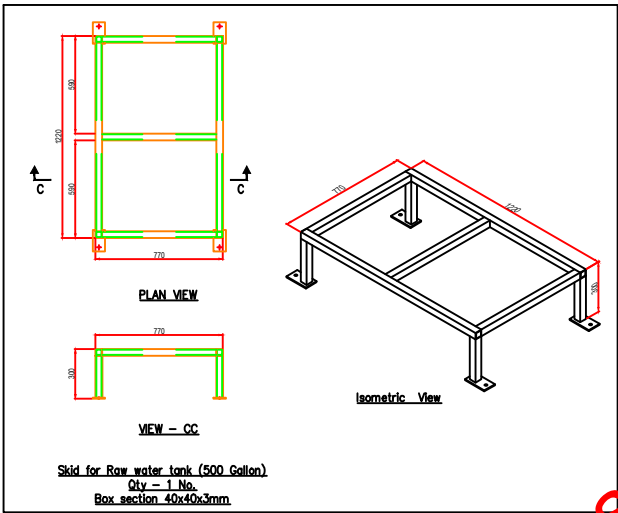

CLIENT NAME:														
XXXXXX														
CONTRACTOR:														
					PROJECT: RO PLANT 20 CMD									
					TITLE: PROCESS & INSTRUMENTATION DIAGRAM									
					DESIGNED		SL				SCALE N.T.S.			
					DRAWN		VP							
					CHECKED		VR							
					APPROVED		OSR							
					REV.		DESCRIPTION		APPD.		DATE		DRG. NO.	
					REVISIONS								SHEET:	
					NOT FOR CONSTRUCTION THIS DRAWING IS A PROPERTY OF GULF POWER CORP. CO. LLC AND MAY NOT BE USED OR REPRODUCED WITHOUT WRITTEN PERMISSION FROM GULF POWER CORP. CO. LLC									

DO NOT SCALE DRAWING

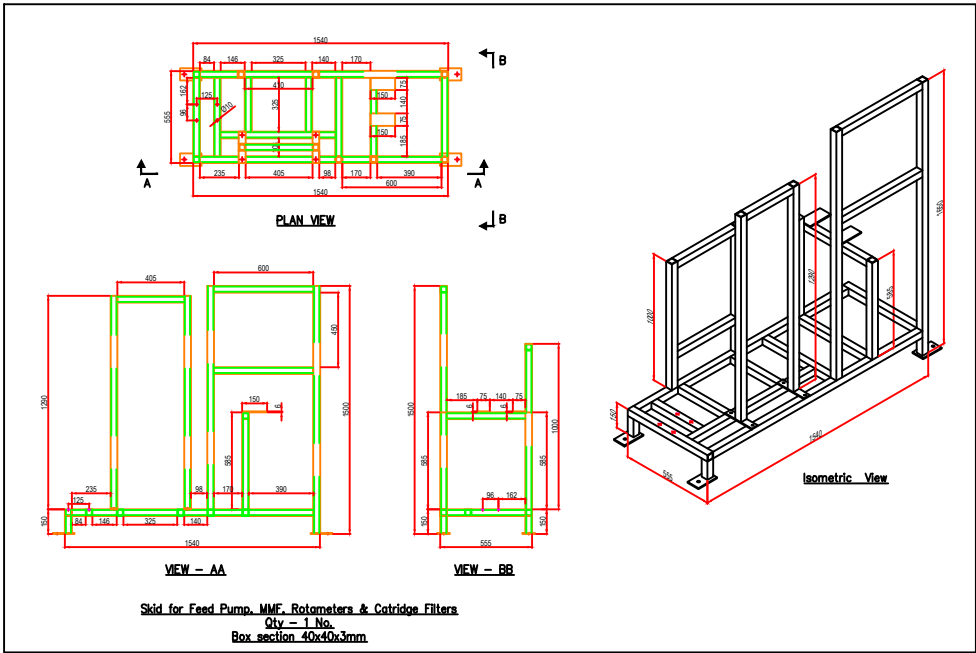

AS BUILT

CLIENT NAME:				XXXXX			
CONTRACTOR:							
				PROJECT: RO PLANT 20 CMD			
				TITLE: PROCESS & INSTRUMENTATION DIAGRAM			
				DESIGNED SL DRAWN VP CHECKED VR APPROVED GSR			
				DRG. NO.  SCALE N.T.S.			
REV.	DESCRIPTION	APP'D.	DATE	THIS DRAWING IS A PROPERTY OF CLAW WATER TREAT CO. LTD. AND NOT TO BE USED OR COPIED WITHOUT PERMISSION			
REVISIONS				SHEET:			